


USE 3'-7" FOR AFF DIMENSION
TO CENTER OF KEYHOLE

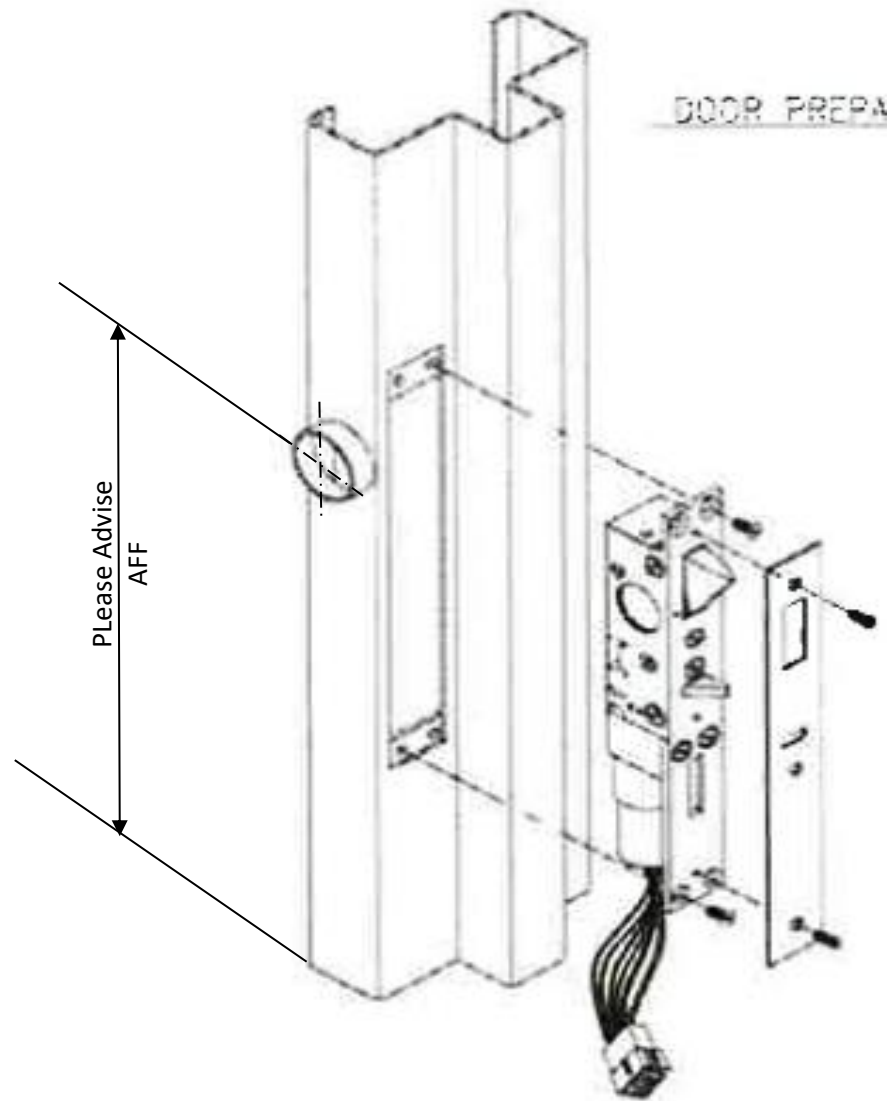

COUNTY OF FRESNO
DEPARTMENT OF PUBLIC WORKS AND PLANNING

Date 06/23/23 By: Matt Lopez

- ☐ NO EXCEPTIONS ☒ MAKE CORRECTIONS NOTED
☐ SUBMIT SPECIFIED ITEM(S) ☐ REVISE AND RESUBMIT
☐ REJECTED. RESUBMIT ☐ COMMENT LETTER ATTACHED

Corrections or Comments made by the County on shop drawings or submittal documents during this review do not relieve the Contractor or his Sub-Contractors of the requirements of the Drawings and Specifications. This Review is only to check for general conformance with the design concept and general compliance with the Contract Documents. The Contractor remains responsible for confirming and correlating all dimensions and quantities; selecting fabrication processes and techniques of construction; coordinating the work of the trades; and performing the work in a safe and satisfactory manner.



PROJECT:	Fresno County Jail			FCW PROJECT	4389	CUSTOMER ORDER No.	
SHEET:	ELEVATION			CONTRACTOR			
ORIG. DATE:	6/13/2023	FCW ENGR:	SR				
LATEST REV:		ARCHT REF:					
SHEET No.							1