


	- TEMPORARY CRASH CUSHION (ABSORB 350 OR EQUIVALENT)
	- TYPE III BARRICADE
	- DIRECTION OF TRAFFIC
	- CHANNELIZER (SURFACE MOUNTED), SPACING 25' Max
	- CONSTRUCTION AREA SIGN
	- TEMPORARY RAILING (TYPE K)

1. FOR COMPLETE RIGHT OF WAY AND ACCURATE ACCESS DATA, SEE RIGHT OF WAY RECORD MAPS AT FRESNO COUNTY OFFICE.
2. MAINTAIN 11' MINIMUM TRAVEL LANES.
3. MAINTAIN CLEAR LINE OF SIGHT AT DRIVEWAYS.
4. INSTALL TEMPORARY HIGH VISIBILITY FENCE (ESA FENCING) PRIOR TO BEGINNING WORK AND PRIOR TO ANY GROUND DISTURBING ACTIVITIES.

5. ALL TEMPORARY PAVEMENT MARKINGS SHALL BE TEMPORARY PAVEMENT MARKING (PAINT).
6. SIGN LOCATIONS ARE APPROXIMATE. EXACT SIGN LOCATIONS TO BE DETERMINED BY THE ENGINEER.
7. CONFLICTING SIGNS TO BE REMOVED OR COVERED DURING CONSTRUCTION AS APPROVED BY THE ENGINEER.
8. FINAL HMA LIFT SHALL BE PLACED DURING LAST STAGE.
9. PORTABLE CHANGEABLE MESSAGE SIGN INCLUDING CONSTRUCTION AREA ADVANCED WARNING SIGNS TO BE INSTALLED PRIOR TO STAGE 1 CONSTRUCTION.

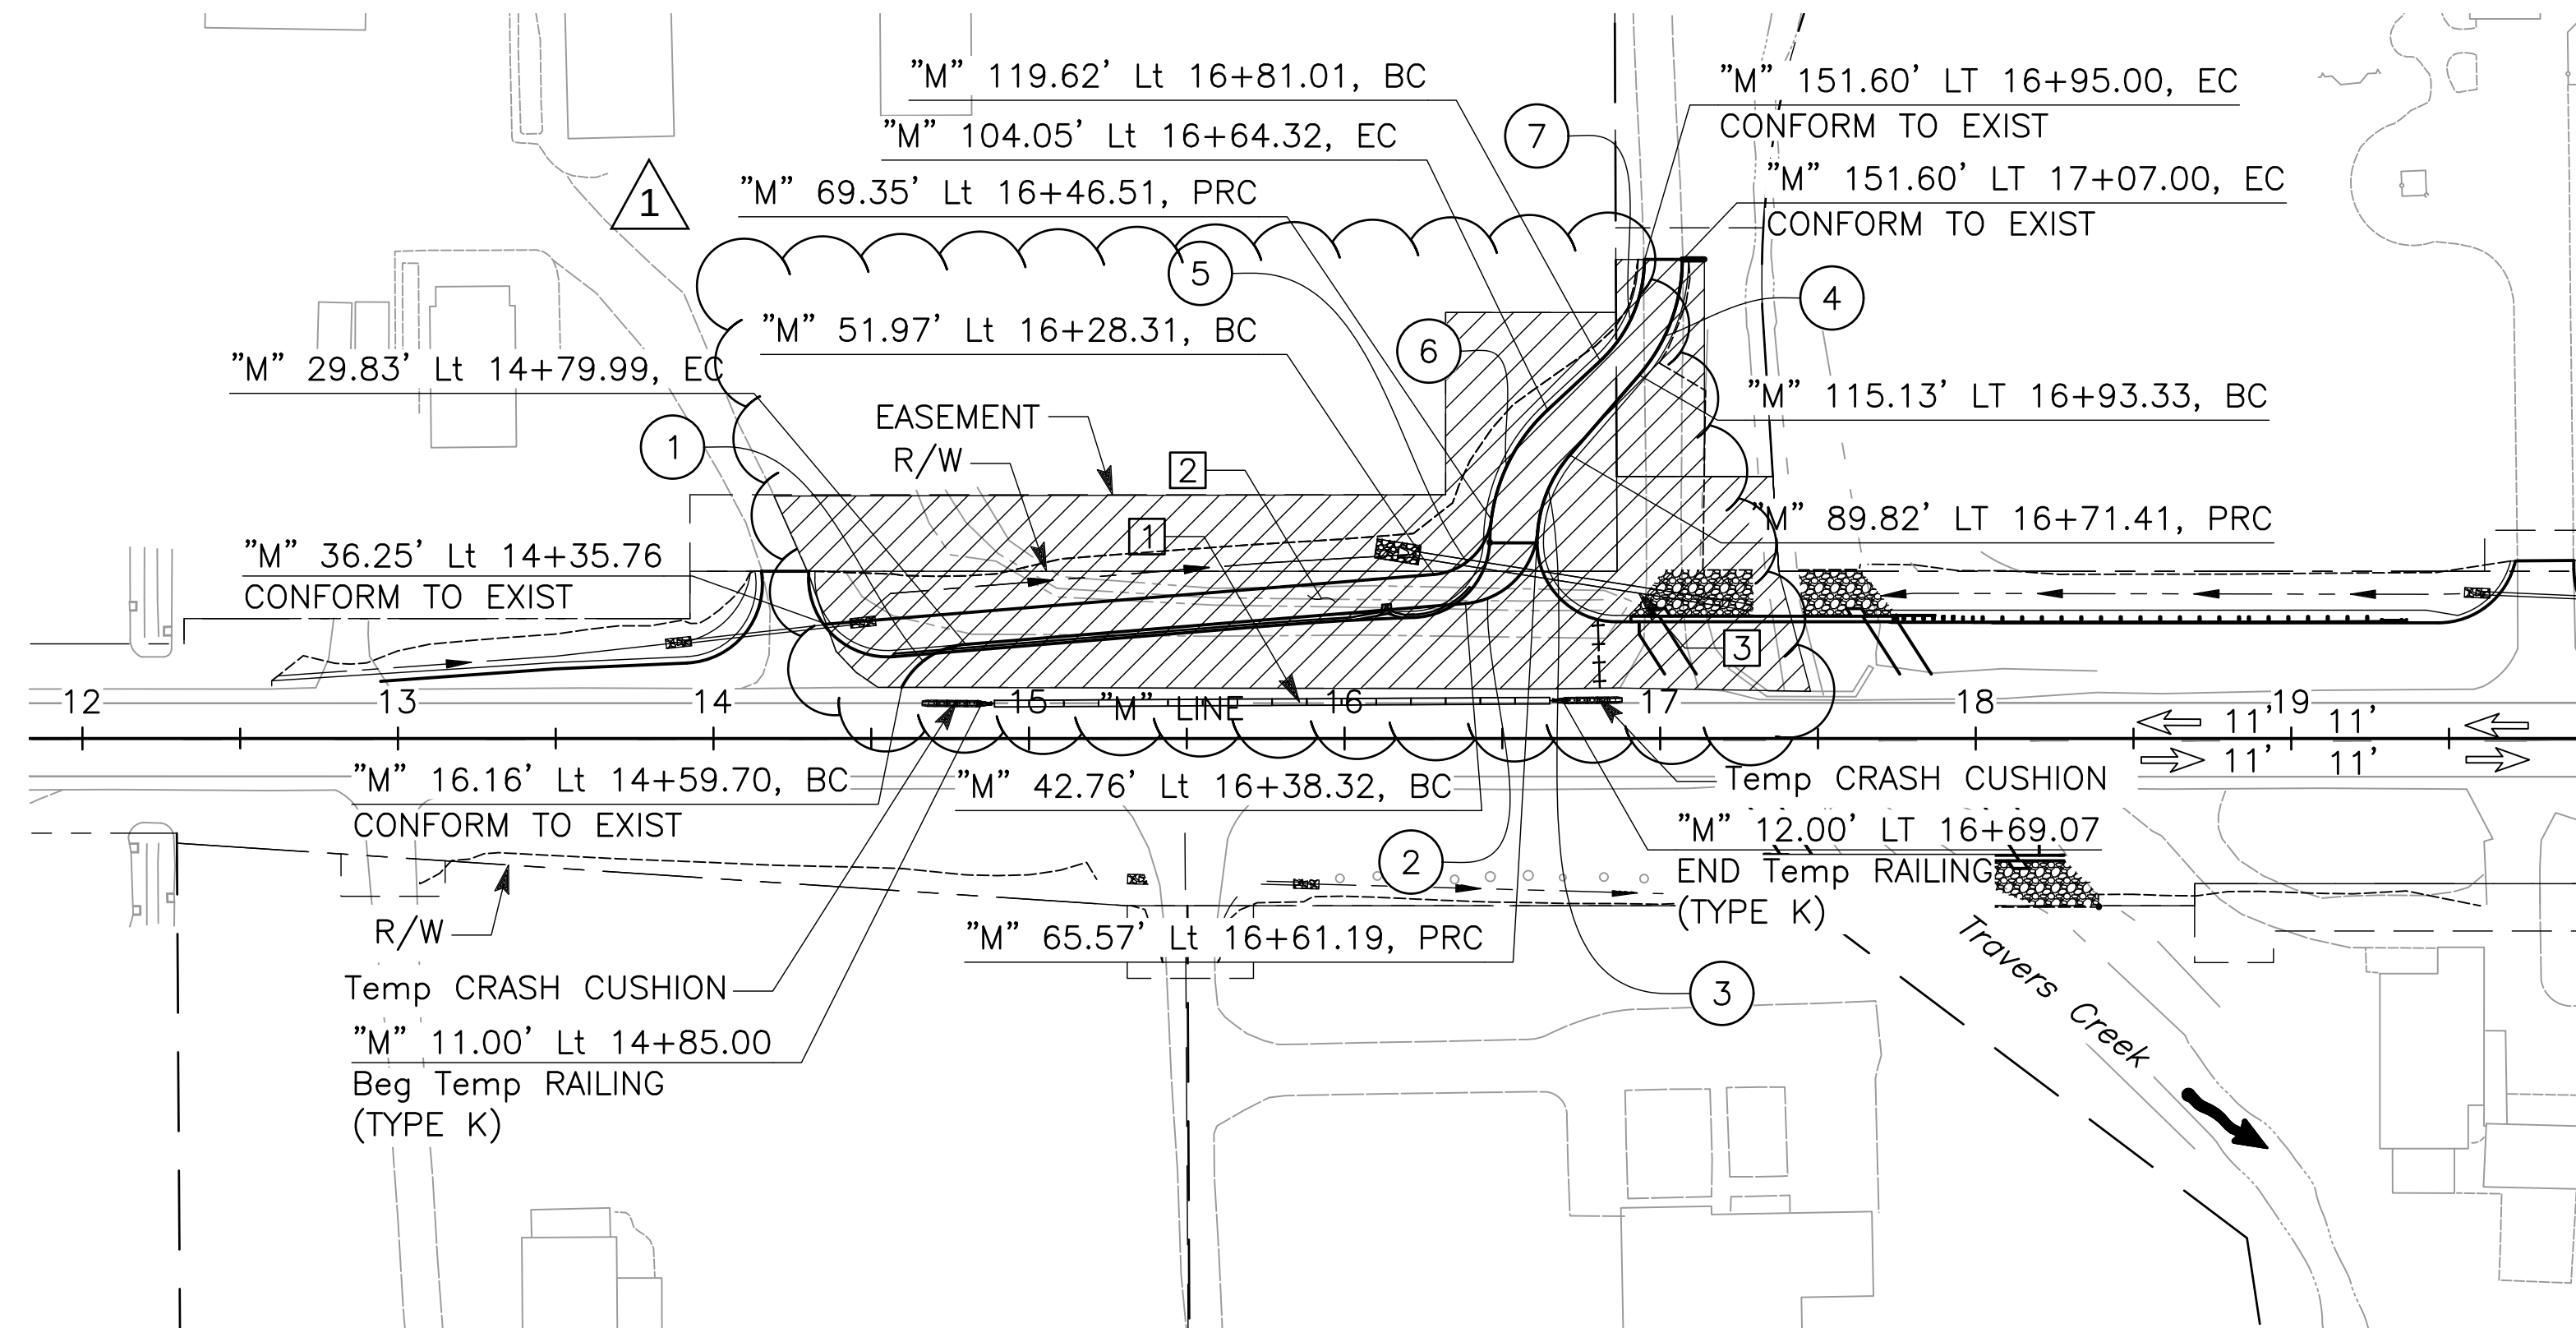

No.	R	Δ	T	L
1	25'	58°35'08"	14.03'	25.56'
2	25'	80°30'33"	21.17'	35.13'
3	42'	36°04'10"	13.84'	26.76'
4	56'	40°53'31"	20.88'	39.97'
5	20'	77°59'14"	16.19'	27.22'
6	58'	39°38'47"	20.73'	39.79'
7	44'	46°59'27"	19.13'	36.09'

- 1 PLACE TEMPORARY RAILING (TYPE K), TEMPORARY CRASH CUSHIONS, TEMPORARY STRIPING, AND OTHER TRAFFIC HANDLING MEASURES ALONG MANNING AVENUE.
- 2 CONSTRUCT TEMPORARY DRIVEWAY USING NATIVE MATERIAL.
- 3 CONSTRUCT 108 LF 24" RCP.

1. MAINTAIN DRIVEWAY ACCESS DURING CONSTRUCTION.
CONSOLIDATE DRIVEWAYS AS NEEDED.

1 SHEET SC-1 DRAINAGE MODIFICATIONS

	DATE	RECORD DRAWING		SCALE		PROJECT		DEPARTMENT OF PUBLIC WORKS AND PLANNING						
DESIGNED: EB	08/11/26	RESIDENT ENGINEER	DATE	HORIZ 050'100'		TRAVERS CREEK BRIDGE ON MANNING AVENUE		STAGE CONSTRUCTION AND TRAFFIC HANDLING PLAN STAGE 1A						
DRAWN: CM	08/11/26													
CHECKED: GG	08/11/26													
FOR RIGHT OF WAY DATA AND ACCURATE ACCESS DETERMINATION, SEE DOCUMENTS IN THE DEPARTMENT OF PUBLIC WORKS AND PLANNING.					REGISTERED PROFESSIONAL ENGINEER   Dewberry® DEWBERRY ENGINEERING INC. 575 EAST LOCUST AVENUE SUITE 204 FRESNO, CA 93720 <td colspan="2">ROAD NO. S0900</td> <td>BRIDGE NO. 42C-0687</td> <td colspan="2"> SEAL OF THE COUNTY OF FRESNO 1996 </td> <td>DRAWING NO. 11256</td> <td>SHEET NO. SC-1A</td> <td>TOTAL 62</td>		ROAD NO. S0900		BRIDGE NO. 42C-0687	SEAL OF THE COUNTY OF FRESNO 1996		DRAWING NO. 11256	SHEET NO. SC-1A	TOTAL 62