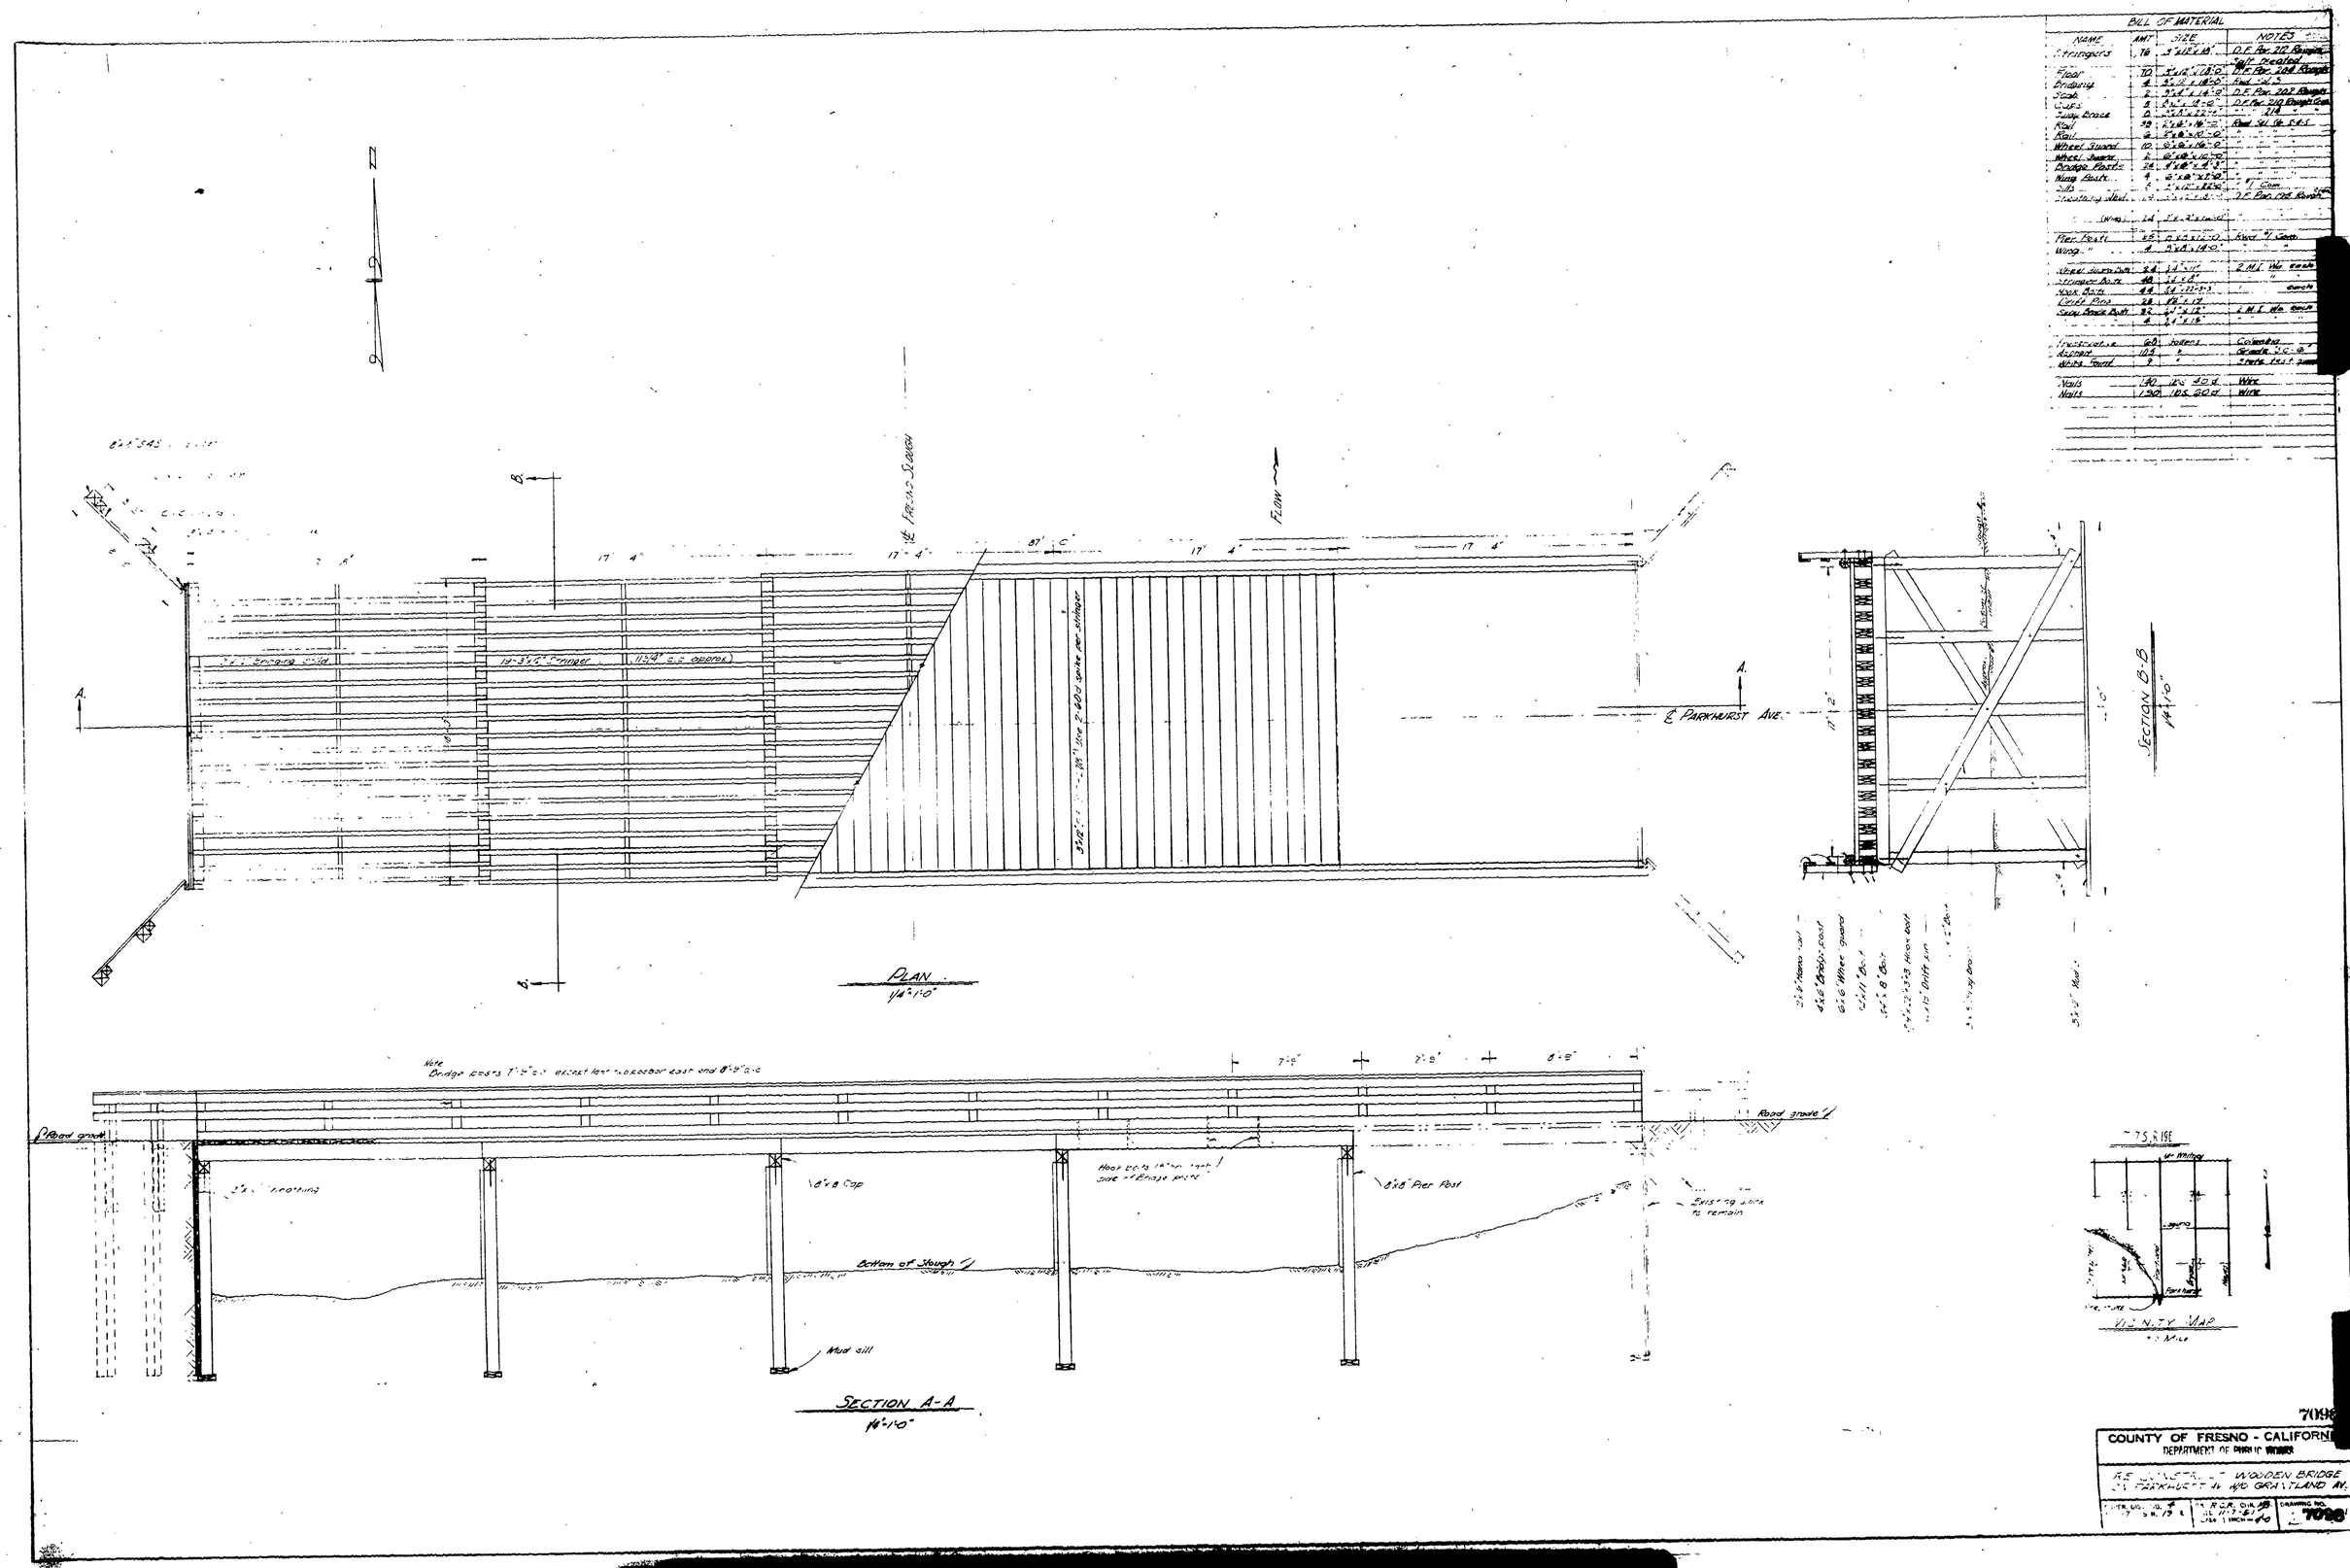

BILL OF MATERIAL			
NAME	AMT	SIZE	NOTES
Stringers	78	3"x12"x18'	D.F. Rgh. 2D Rough
			Split treated
Floor	70	3"x12"x18'-0"	D.F. Rgh. 2D Rough
Bridging	4	3"x8"x18'-0"	Rough
Stock	4	3"x8"x14'-0"	D.F. Rgh. 2D Rough
Curb	8	8"x8"x8'-0"	D.F. Rgh. 2D Rough Com.
Jump Brace	6	2"x8"x22'-0"	" " " "
Rail	39	2"x8"x16'-0"	Rough Sel. Gr. S.P.I.
Rail	6	2"x8"x10'-0"	" " " "
Wheel Guard	10	6"x6"x16'-0"	" " " "
Wheel Guard	6	6"x6"x10'-0"	" " " "
Bridge Posts	24	8"x8"x8'-3"	" " " "
Wing Posts	4	8"x8"x22'-0"	" " " "
Sills	4	8"x8"x22'-0"	" " Com.
Sheeting (Wed.)	14	2"x12"x16'-0"	D.F. Rgh. 1S1E Rough
(Wing)	14	2"x12"x16'-0"	" " " "
Pier Posts	25	8"x8"x11'-0"	Rough " " Com.
Wing "	4	8"x8"x14'-0"	" " " "
Wheel Guard Bolts	24	3/4"x11"	2 M.I. Wr. each
Stringer Bolts	48	3/4"x8"	" "
Hook Bolts	44	3/4"x22'-0"	each
Knee Braces	28	1"x12"	"
Curb Brace Bolts	56	3/4"x12"	2 M.I. Wr. each
	4	3/4"x16"	" " "
Preservative	60	Gallons	Coumaru
Asphalt	104	#	Grade "S.C.-0"
White Sand	7	"	Grade "Fine"
Nails	150	20s 40d	Wire
Nails	150	10s 60d	Wire

REDUCED PLANS
USE SCALE BELOW
3" ON ORIGINAL PLANS

4 - 93